




THIRD FLOOR 0" 5" 10"

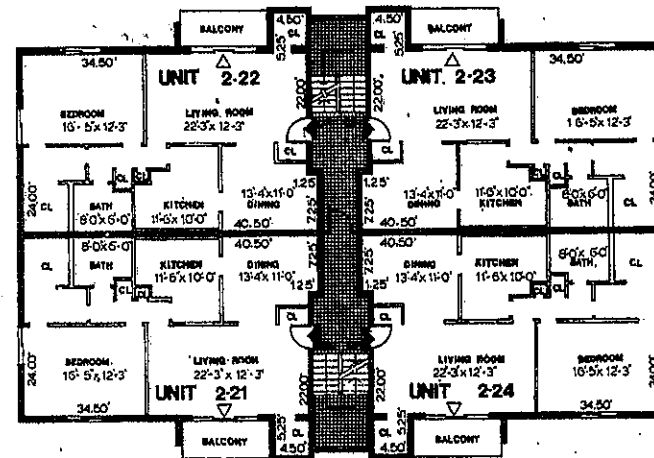


SECOND FLOOR 0" 5" 10"

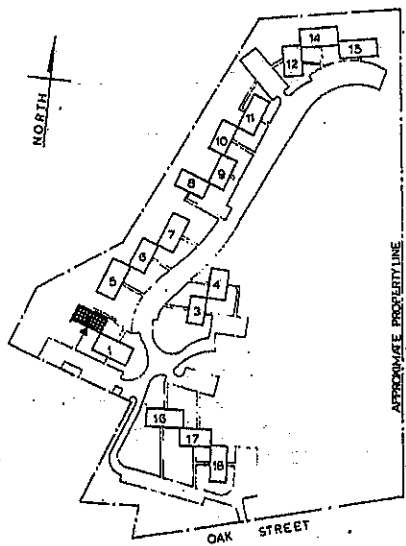


SITE PLAN

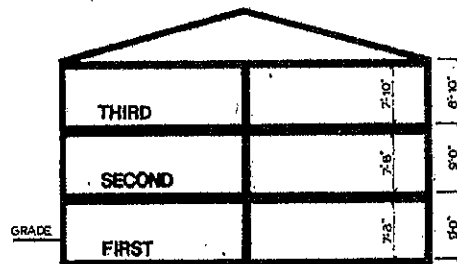

BUILDING SECTION

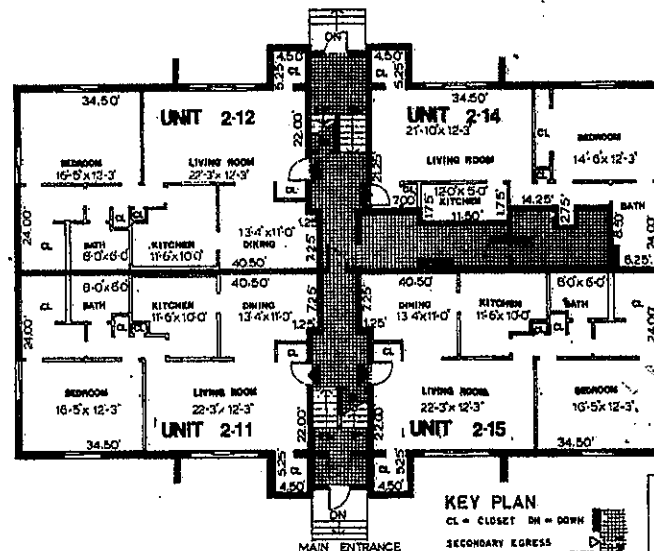

FIRST FLOOR 0" 5" 10"

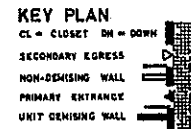

KEY PLAN

REVISIONS	SHEET NO.
	2

I certify that this plan conforms to the rules and regulations of the Registry of Deeds, Commonwealth of Massachusetts. I certify that this plan on 2 of 17 sheets, numbered 1 to 17, fully and accurately depicts the layout, location, unit number and dimensions of the units numbered 2-11, 2-12, 2-14, 2-15, 2-21, 2-22, 2-23, 2-24, 2-31, 2-32, 2-33, 2-34, as built. This building has no use as of the date hereof.



DOUGLAS OKUN & ASSOCIATES

156 MT. ALBURN STREET
CAMBRIDGE, MASSACHUSETTS 02138.

TELEPHONE
491-4600

Fairway Oaks Condominium 221 OAK STREET BROCKTON MA. 02401

title FLOOR PLANS, BUILDING SECTION & SITE PLAN

scale AS NOTED

date 1-18-82

drawn RLM

checked

job no.

1 Bedroom layout