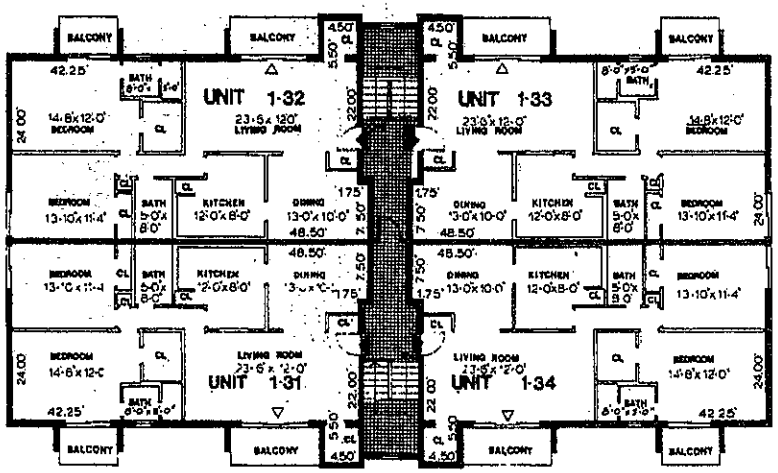

THIRD FLOOR

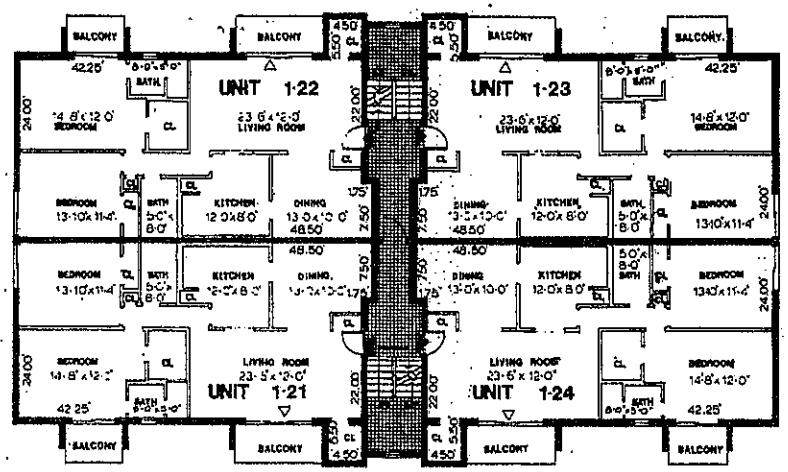

SECOND FLOOR

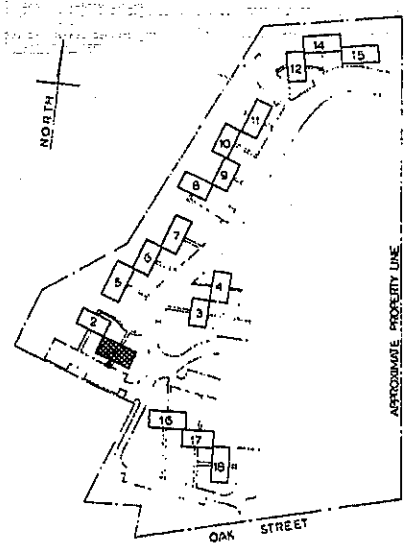

SITE PLAN

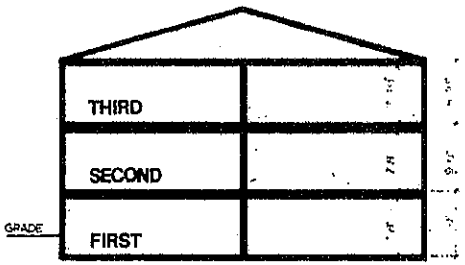

BUILDING SECTION

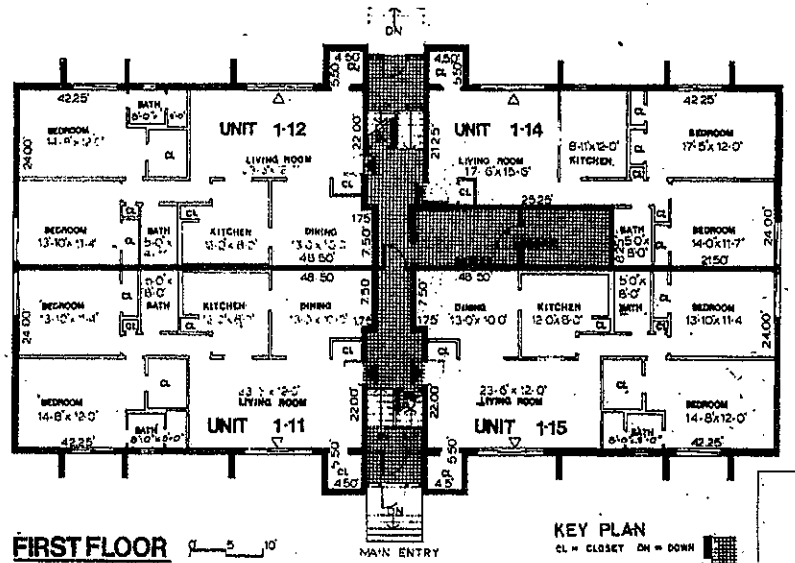

FIRST FLOOR

KEY PLAN
CL = CLOSET DN = DOWN
SECONDARY EGRESS
NON-DEMISING WALL
PRIMARY ENTRANCE
UNIT DEMISING WALL

I certify that this plan conforms to the rules and regulations of the Registry of Deeds, Commonwealth of Massachusetts.

I certify that this plan on #1 of 17 sheets, numbered 1 to 17, fully and accurately depicts the layout, location, unit number and dimensions of the units numbered [illegible] at 221 Oak Street Brockton, MA. as built. This building has no name as of the date hereof.

DOUGLAS OKUN & ASSOCIATES
156 MT. AUBURN STREET
CAMBRIDGE, MASSACHUSETTS 02138.
TELEPHONE 491-4600

Fairway Oaks Condominium 221 OAK STREET BROCKTON MA. 02401

title	scale	date	drawn	checked	job no.	revisions	sheet no.
FLOOR PLANS, BUILDING SECTION & SITE PLAN	AS NOTED		RUM				1

2 Bedroom Layout